

10m 20m 30m

1 : 200


St. Elisabeth heritage garden


Seunghan Yeum (4572076)

Basement plan

Black line : Existing

Red line : Renovated

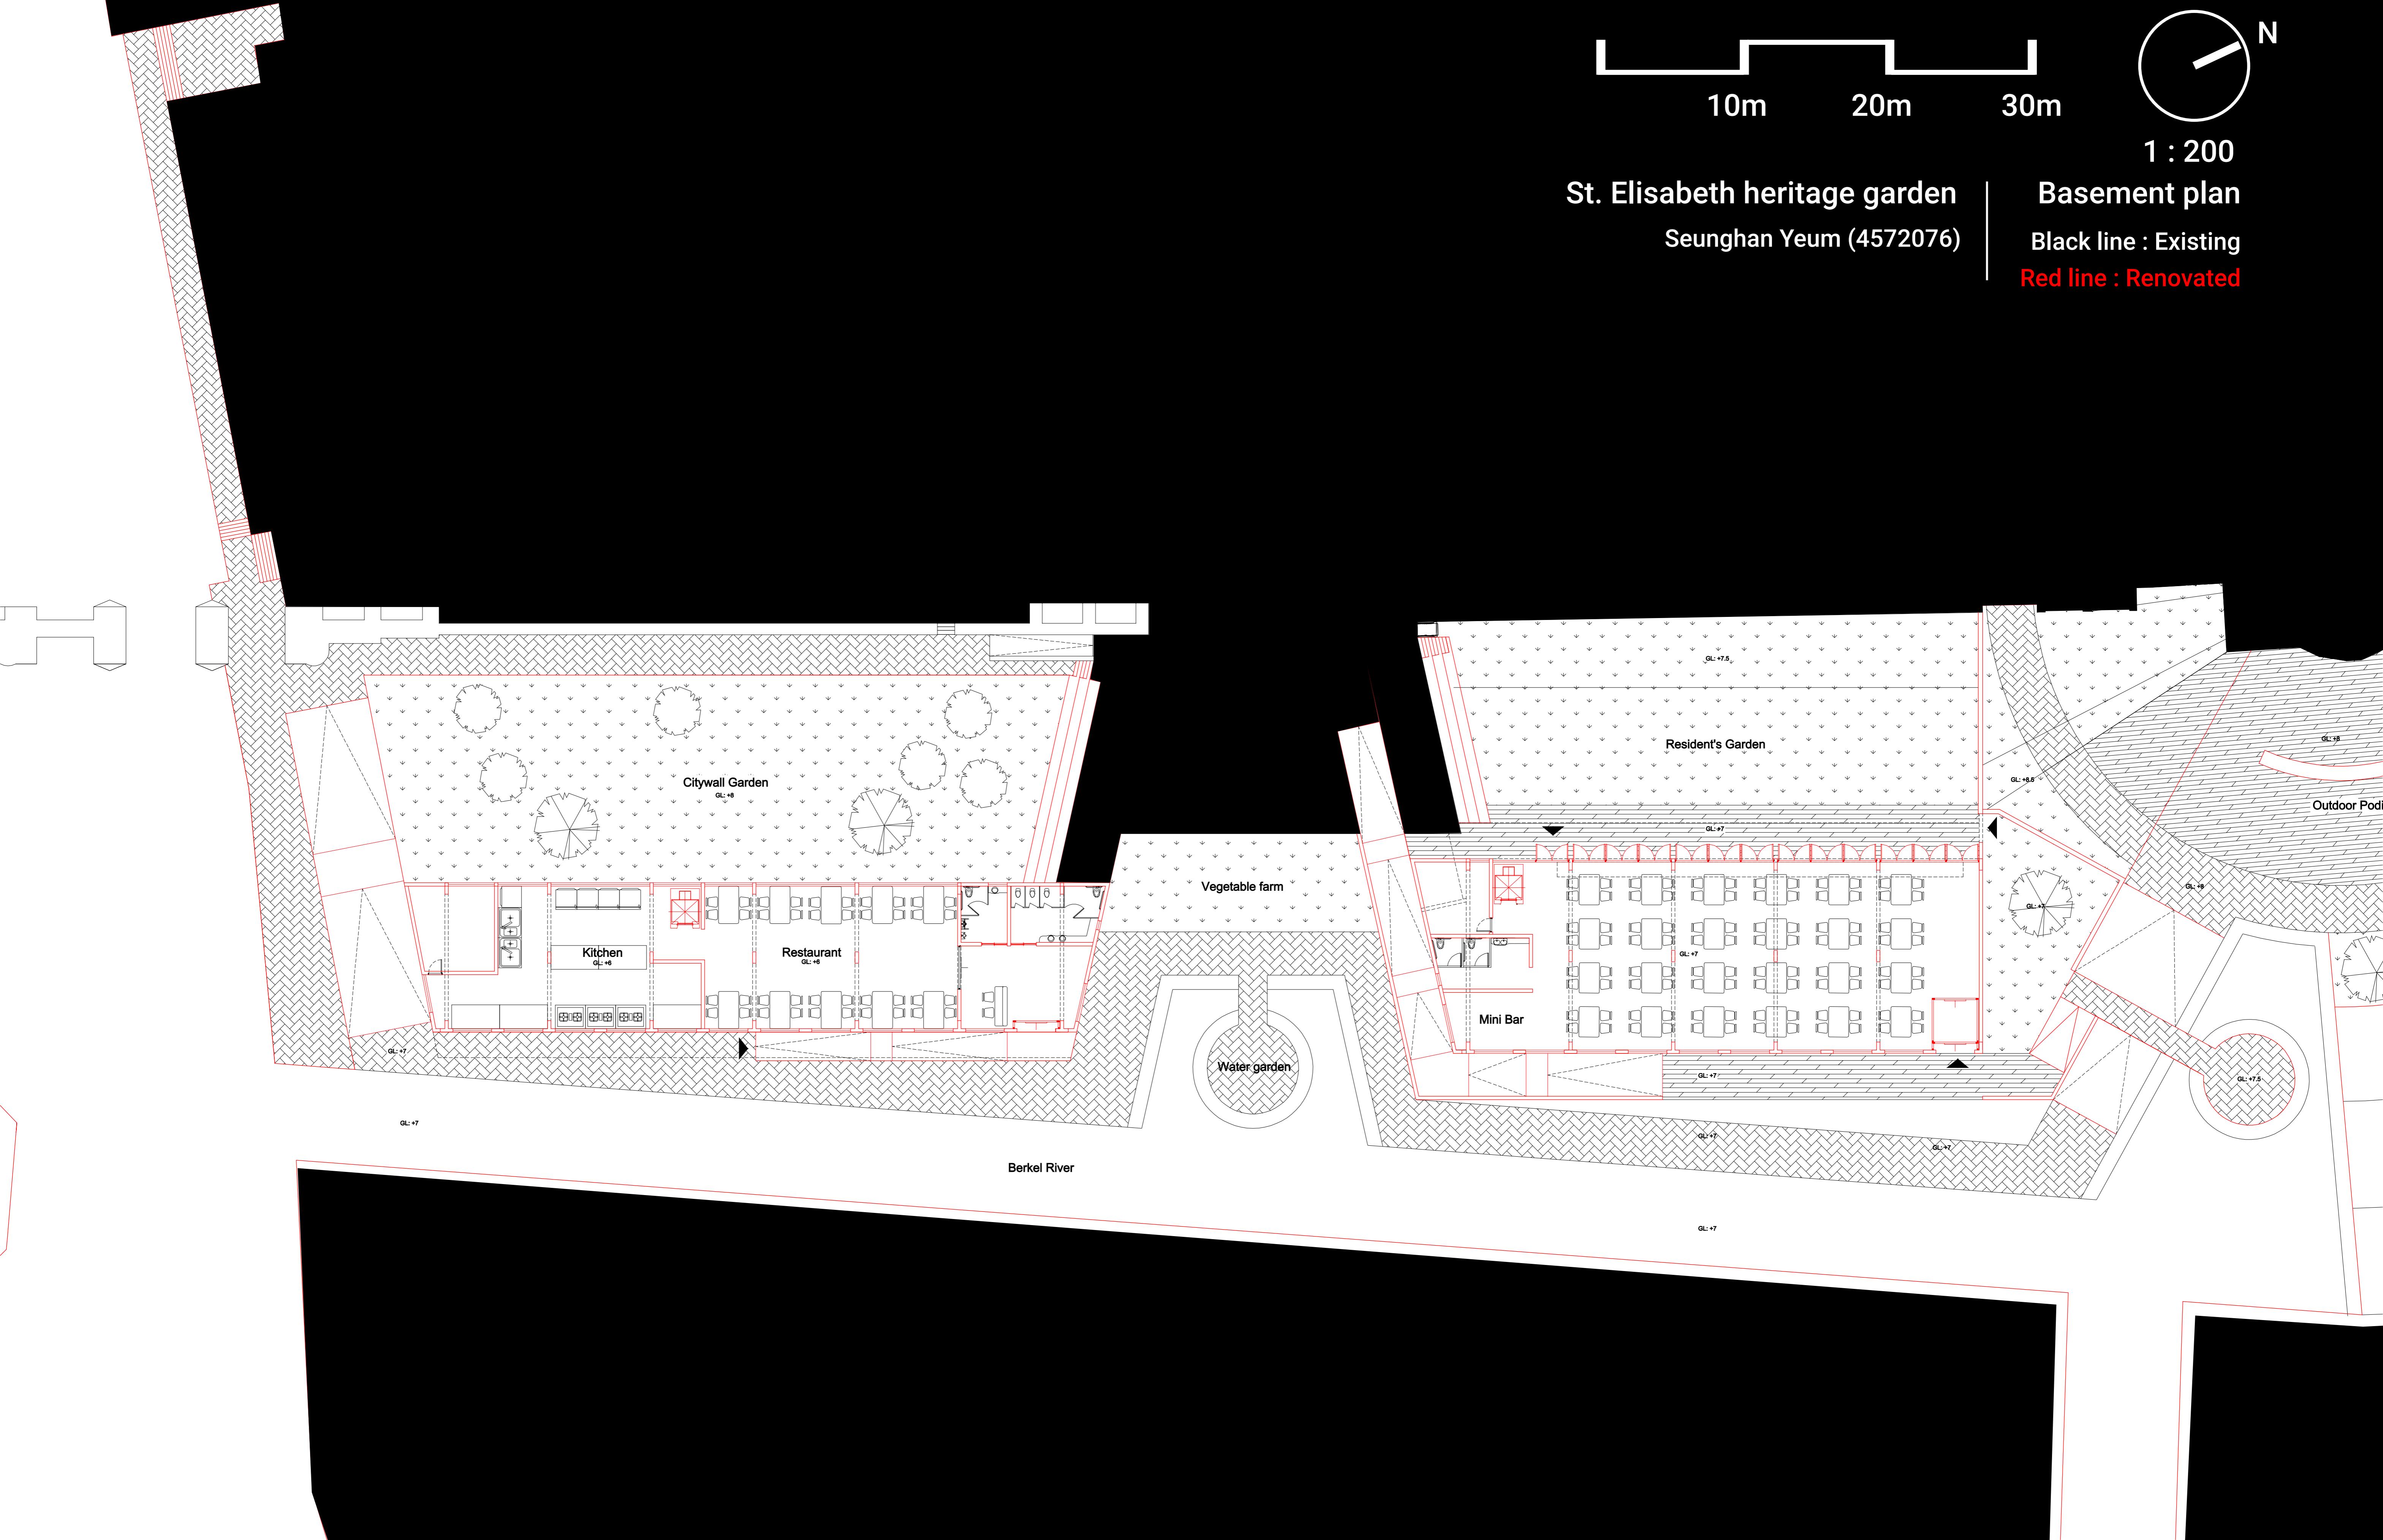

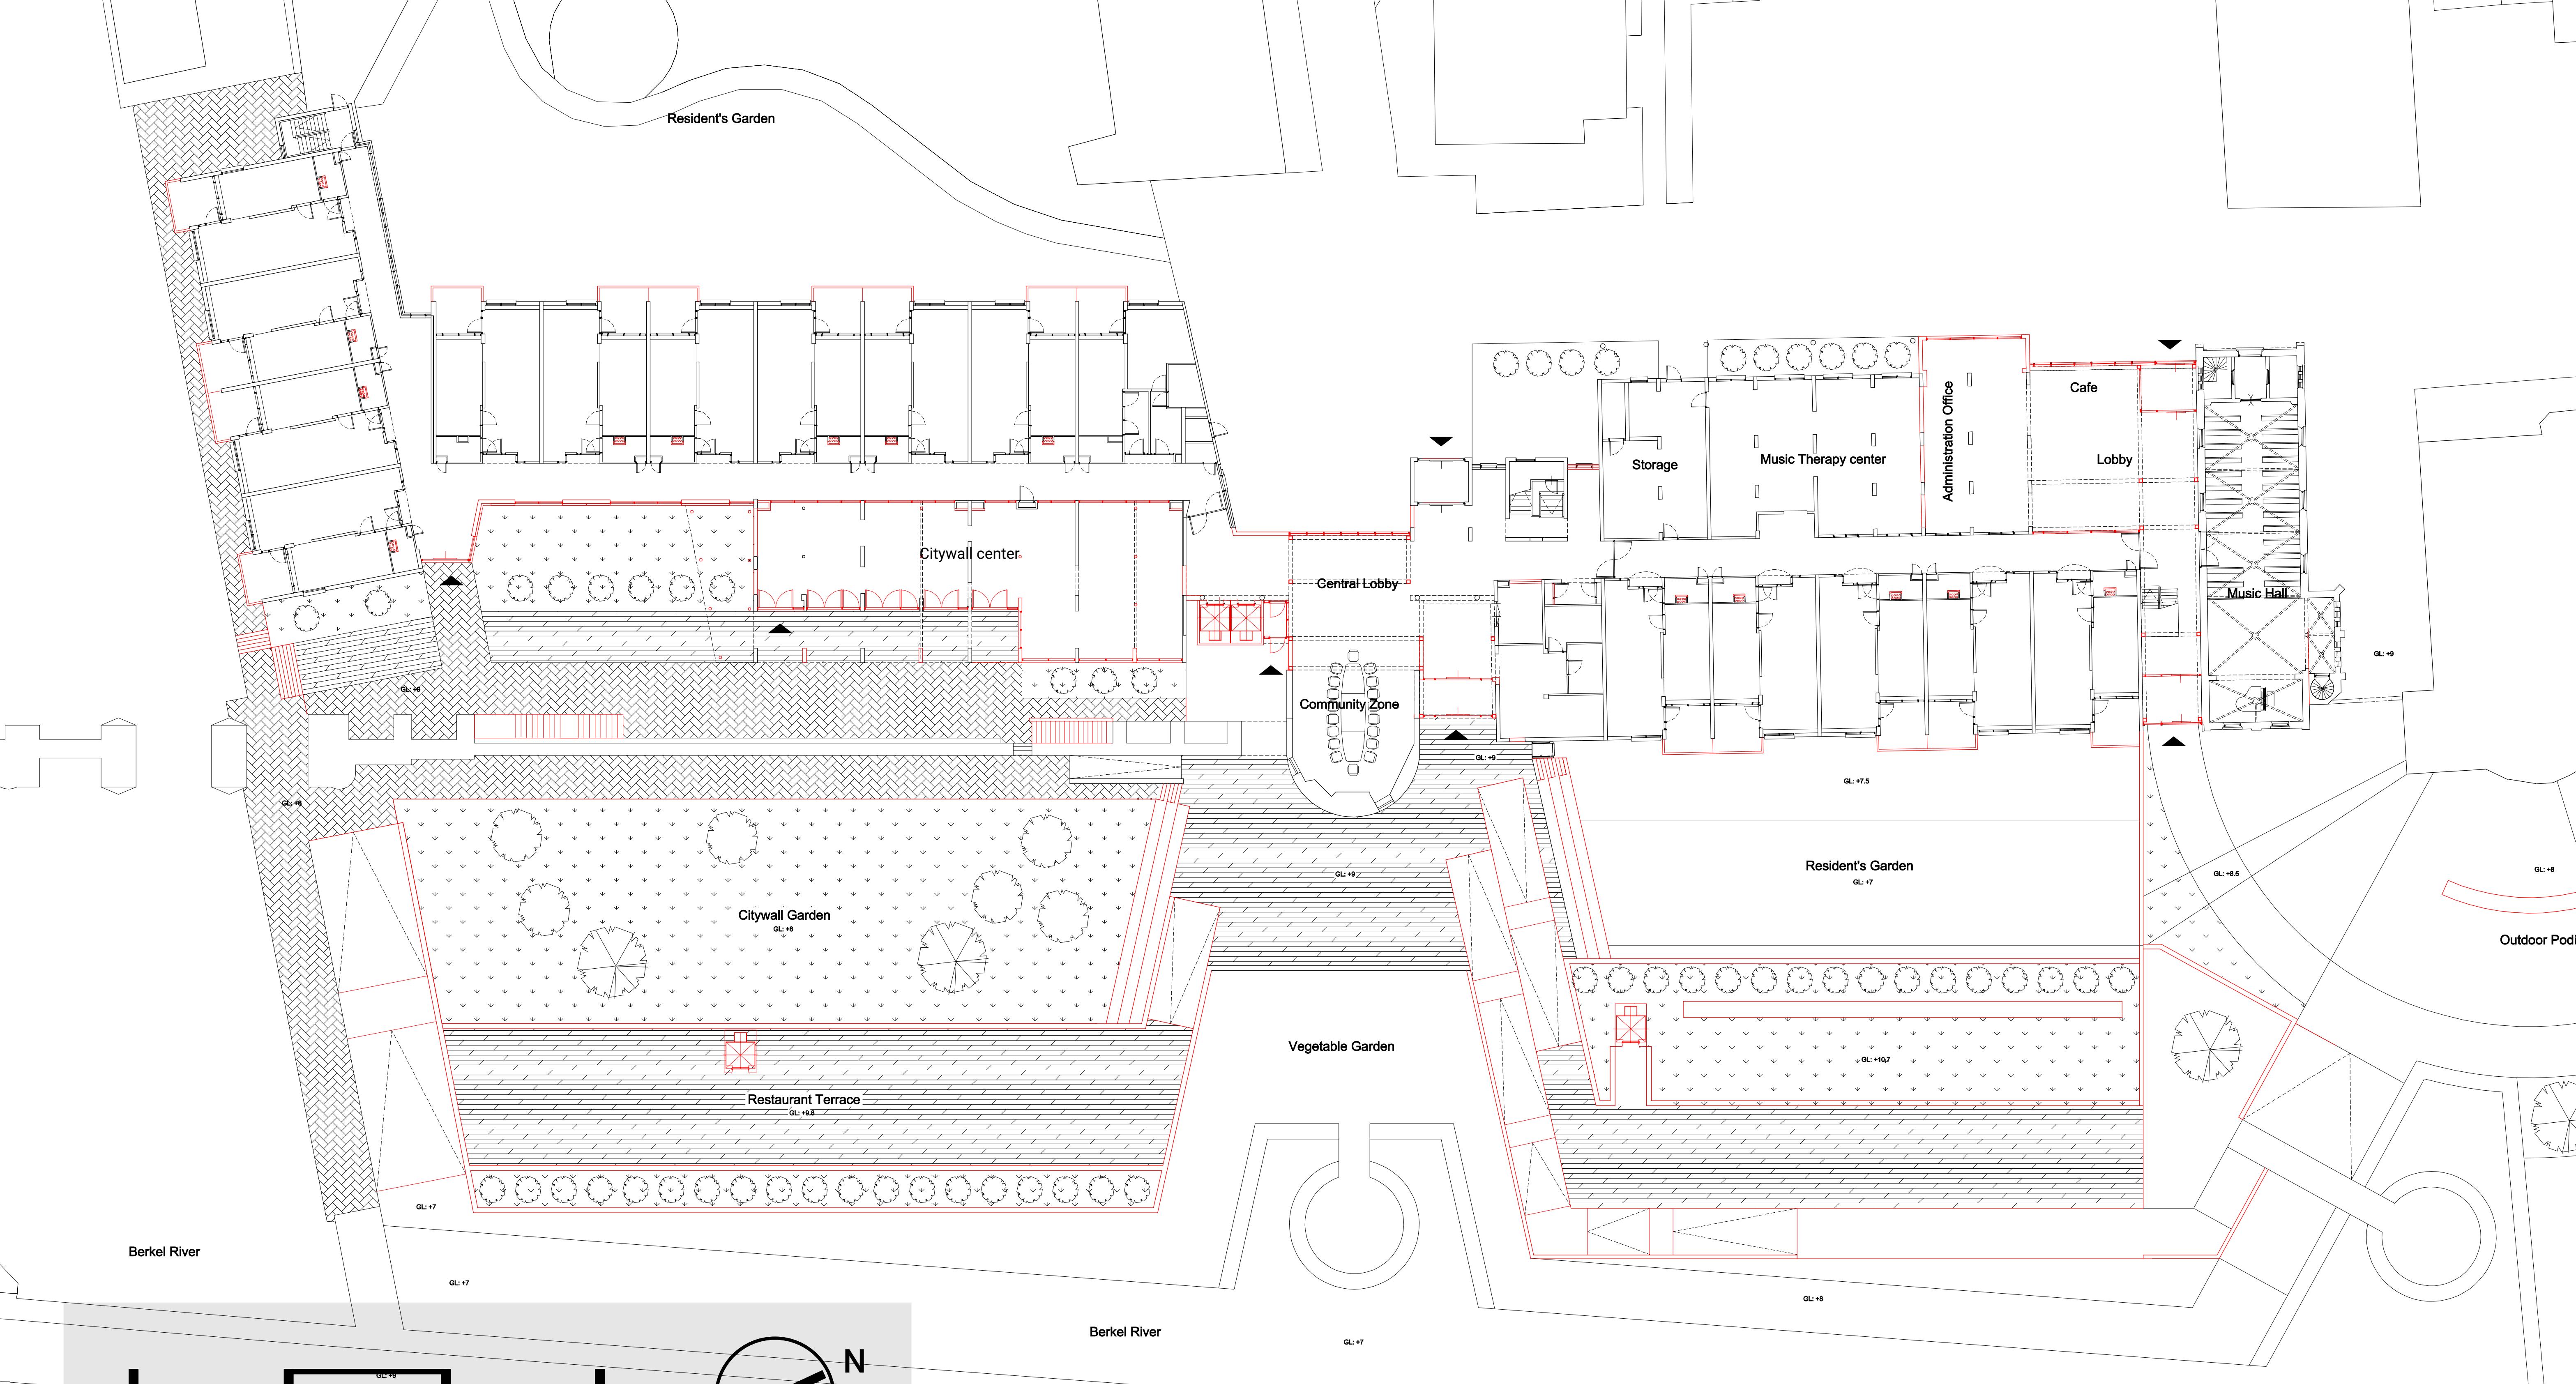

St. Elisabeth heritage garden
Seunghan Yeum (4572076)


Ground floor plan
Black line : Existing
Red line : Renovated

1 : 200


10m 20m 30m

N


Berkel River

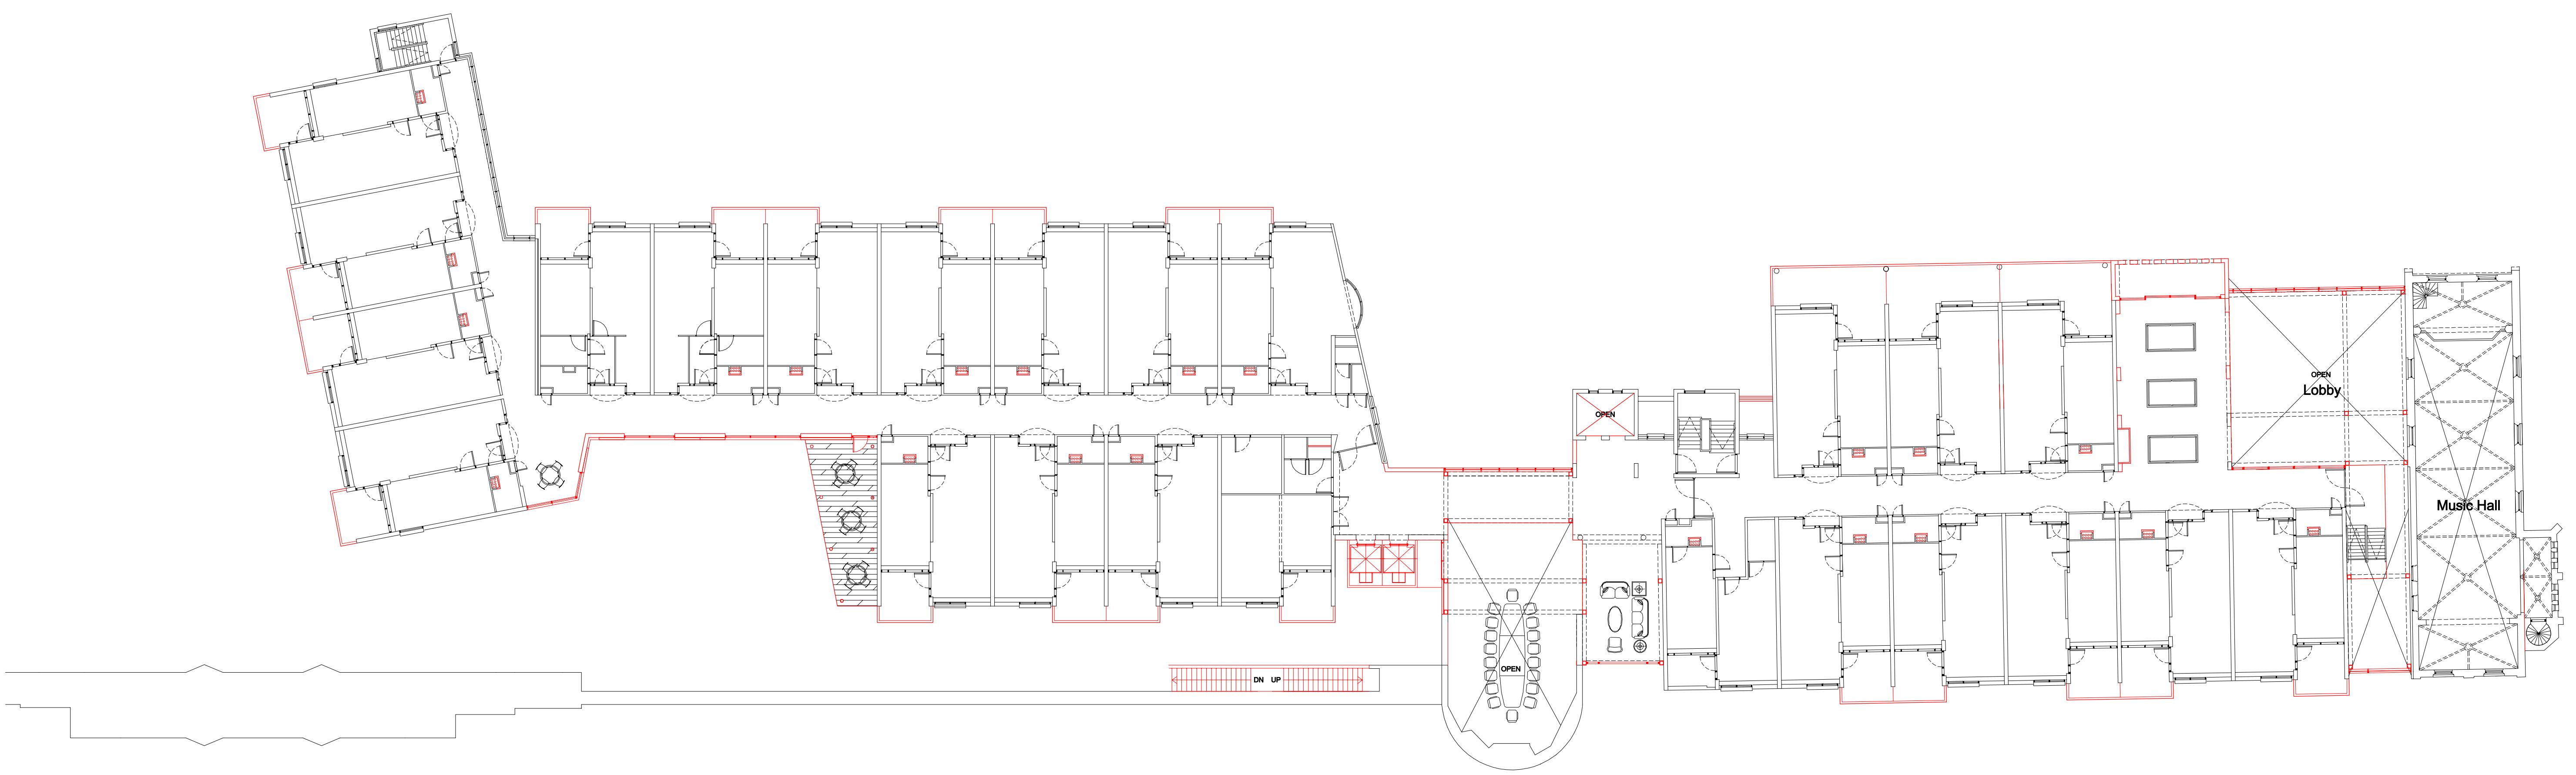


1F

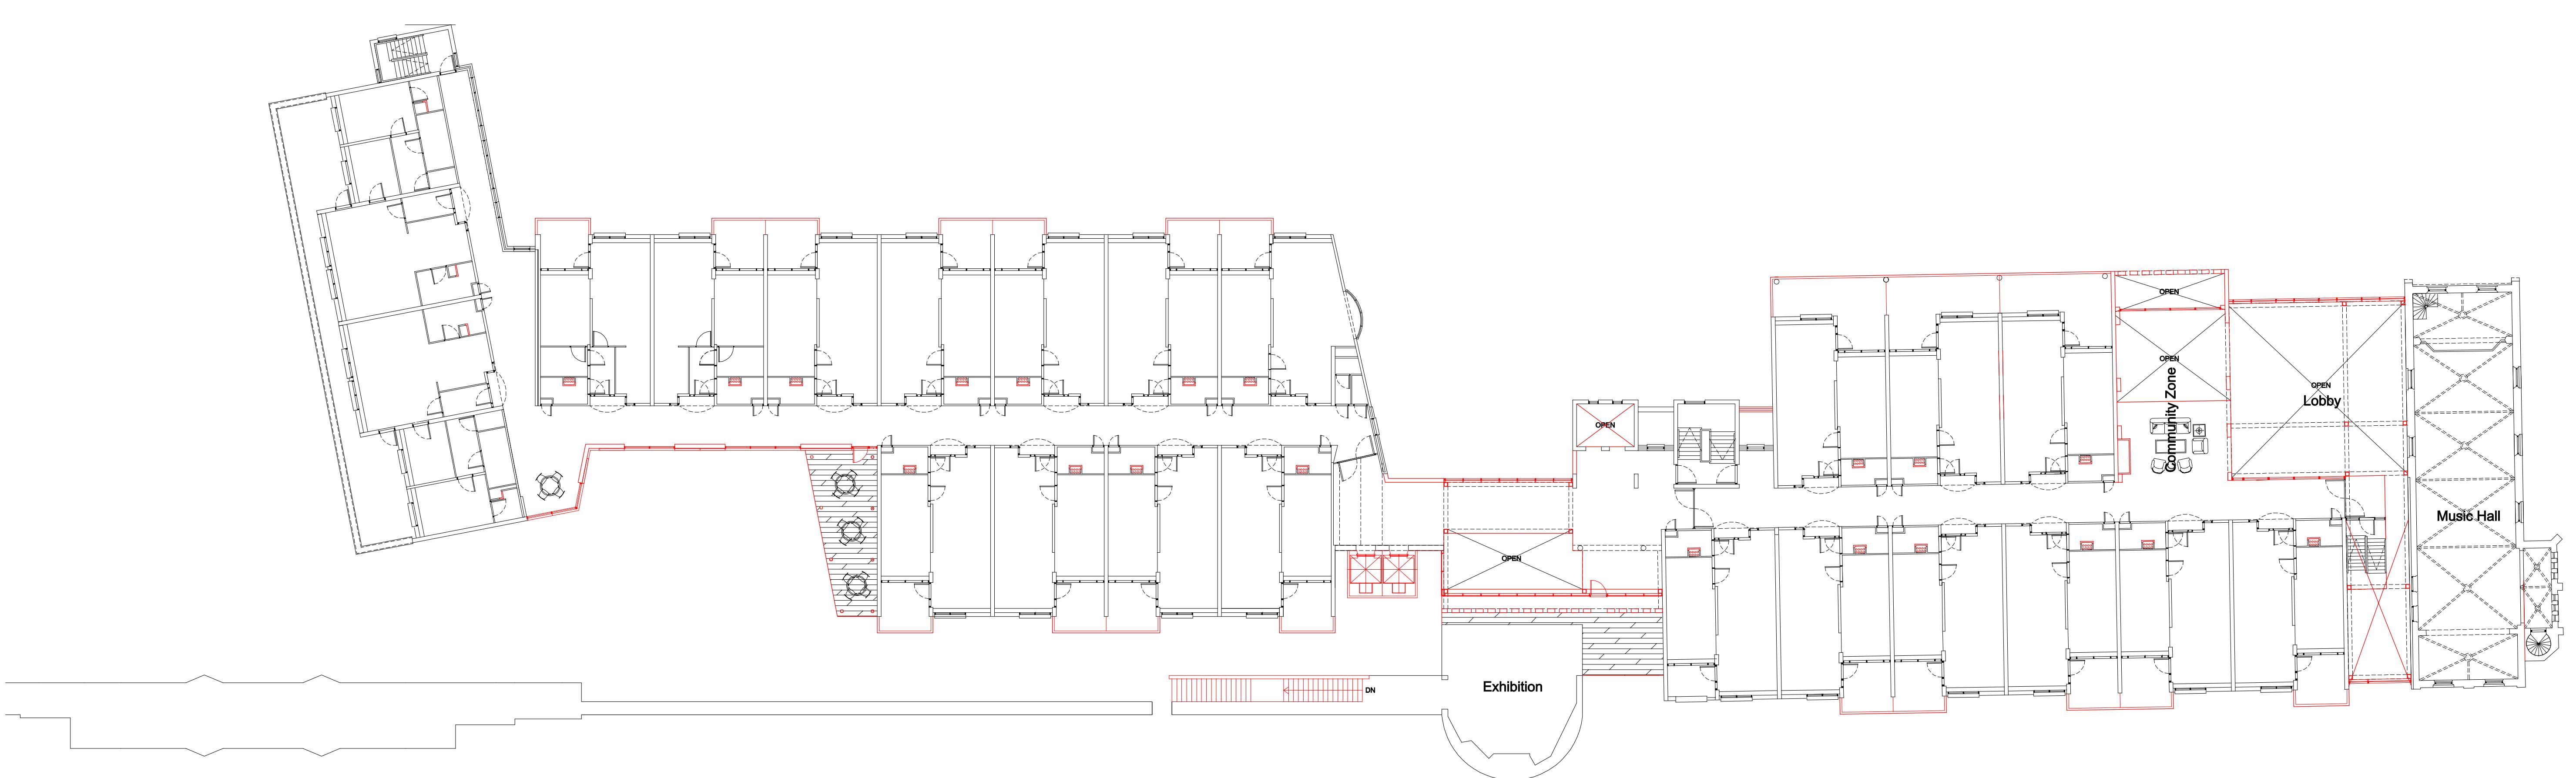

2F

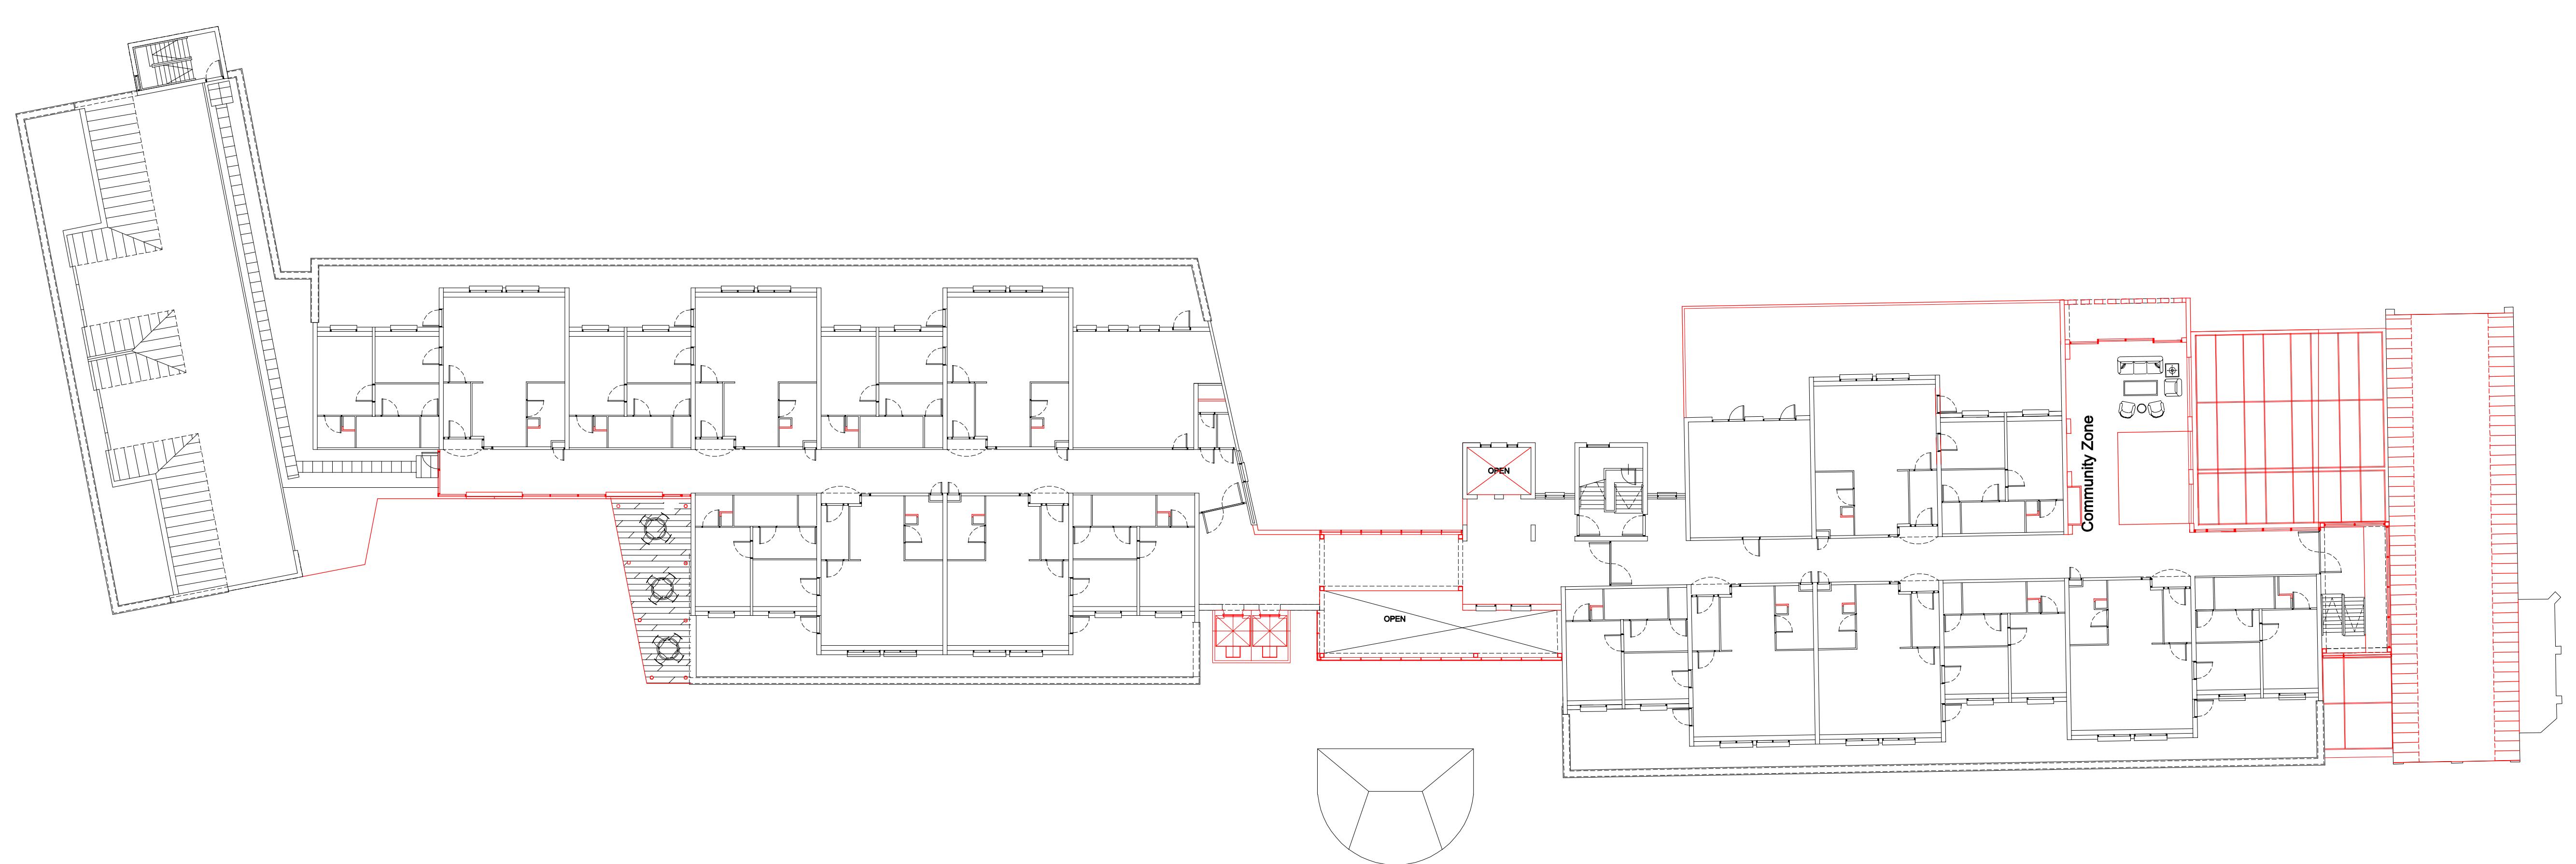

3F

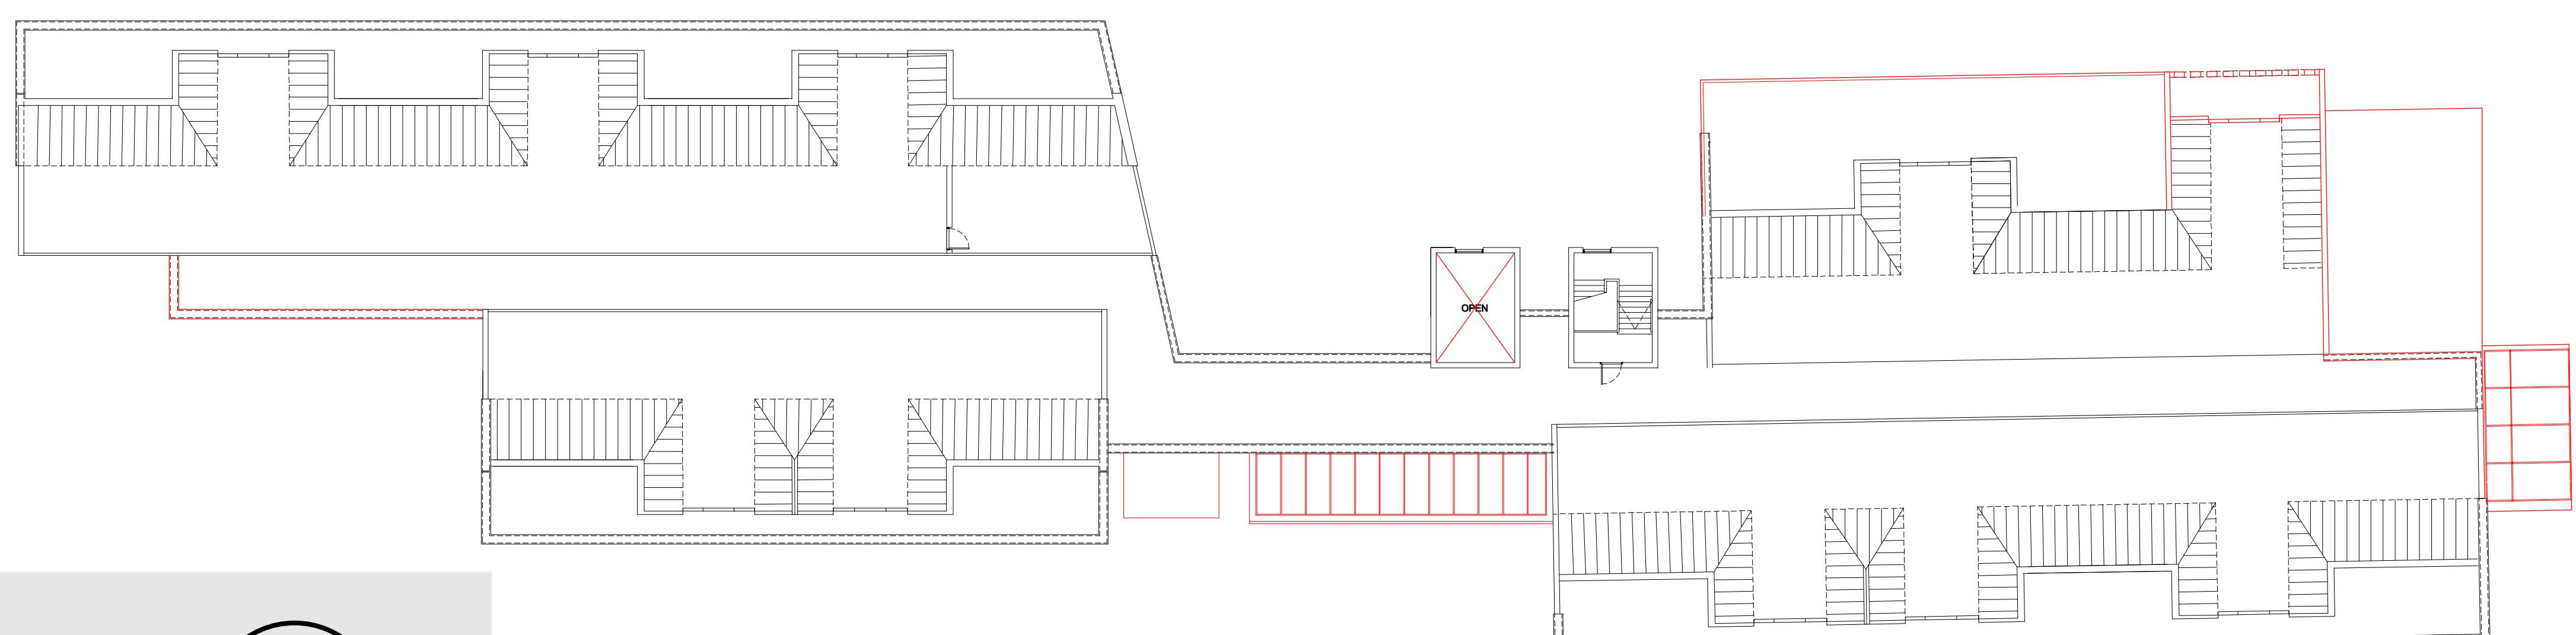

RF

St. Elisabeth heritage garden
 Seunghan Yeum (4572076)
 1 : 200
 Floor plans
 Black line : Existing
 Red line : Renovated

10m 20m 30m

